



וְיִשְׂרָאֵל וְיִשְׂרָאֵל

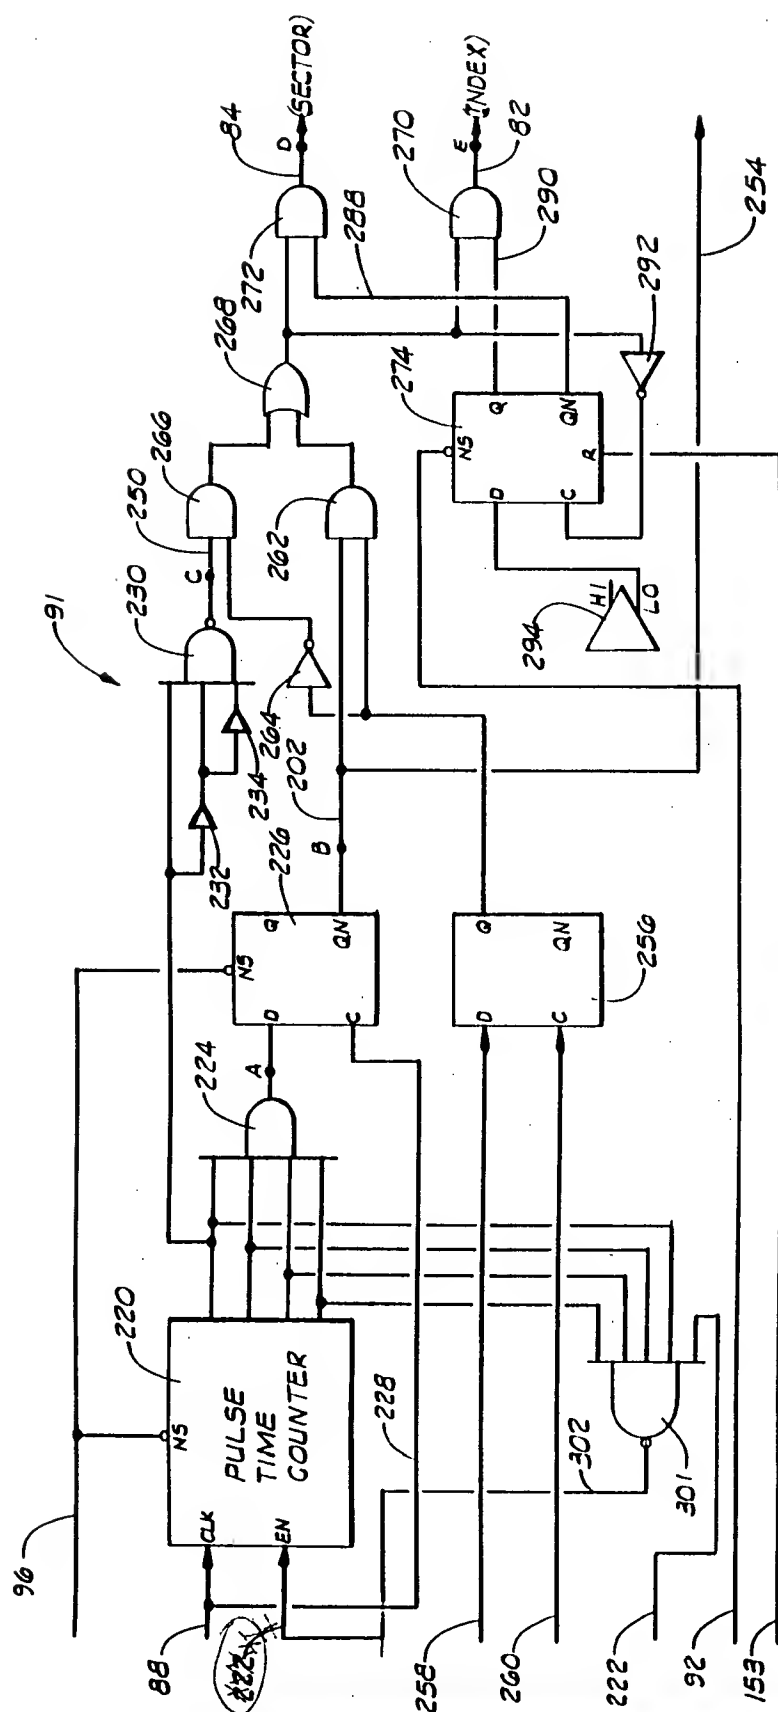

明倫

II. B

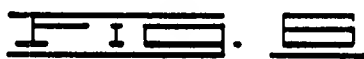

Red Line for
Examiner's Approval

